

SUITE: 210

RSF: 6,856



611BRAND

AS-BUILT CONFIGURATION

OFFICES.....	5
RECEPTION.....	1
CONFERENCE ROOMS.....	2
KITCHEN.....	1
OPEN WORK AREA.....	33

Not to scale, furniture and appliances not included

KEY PLAN

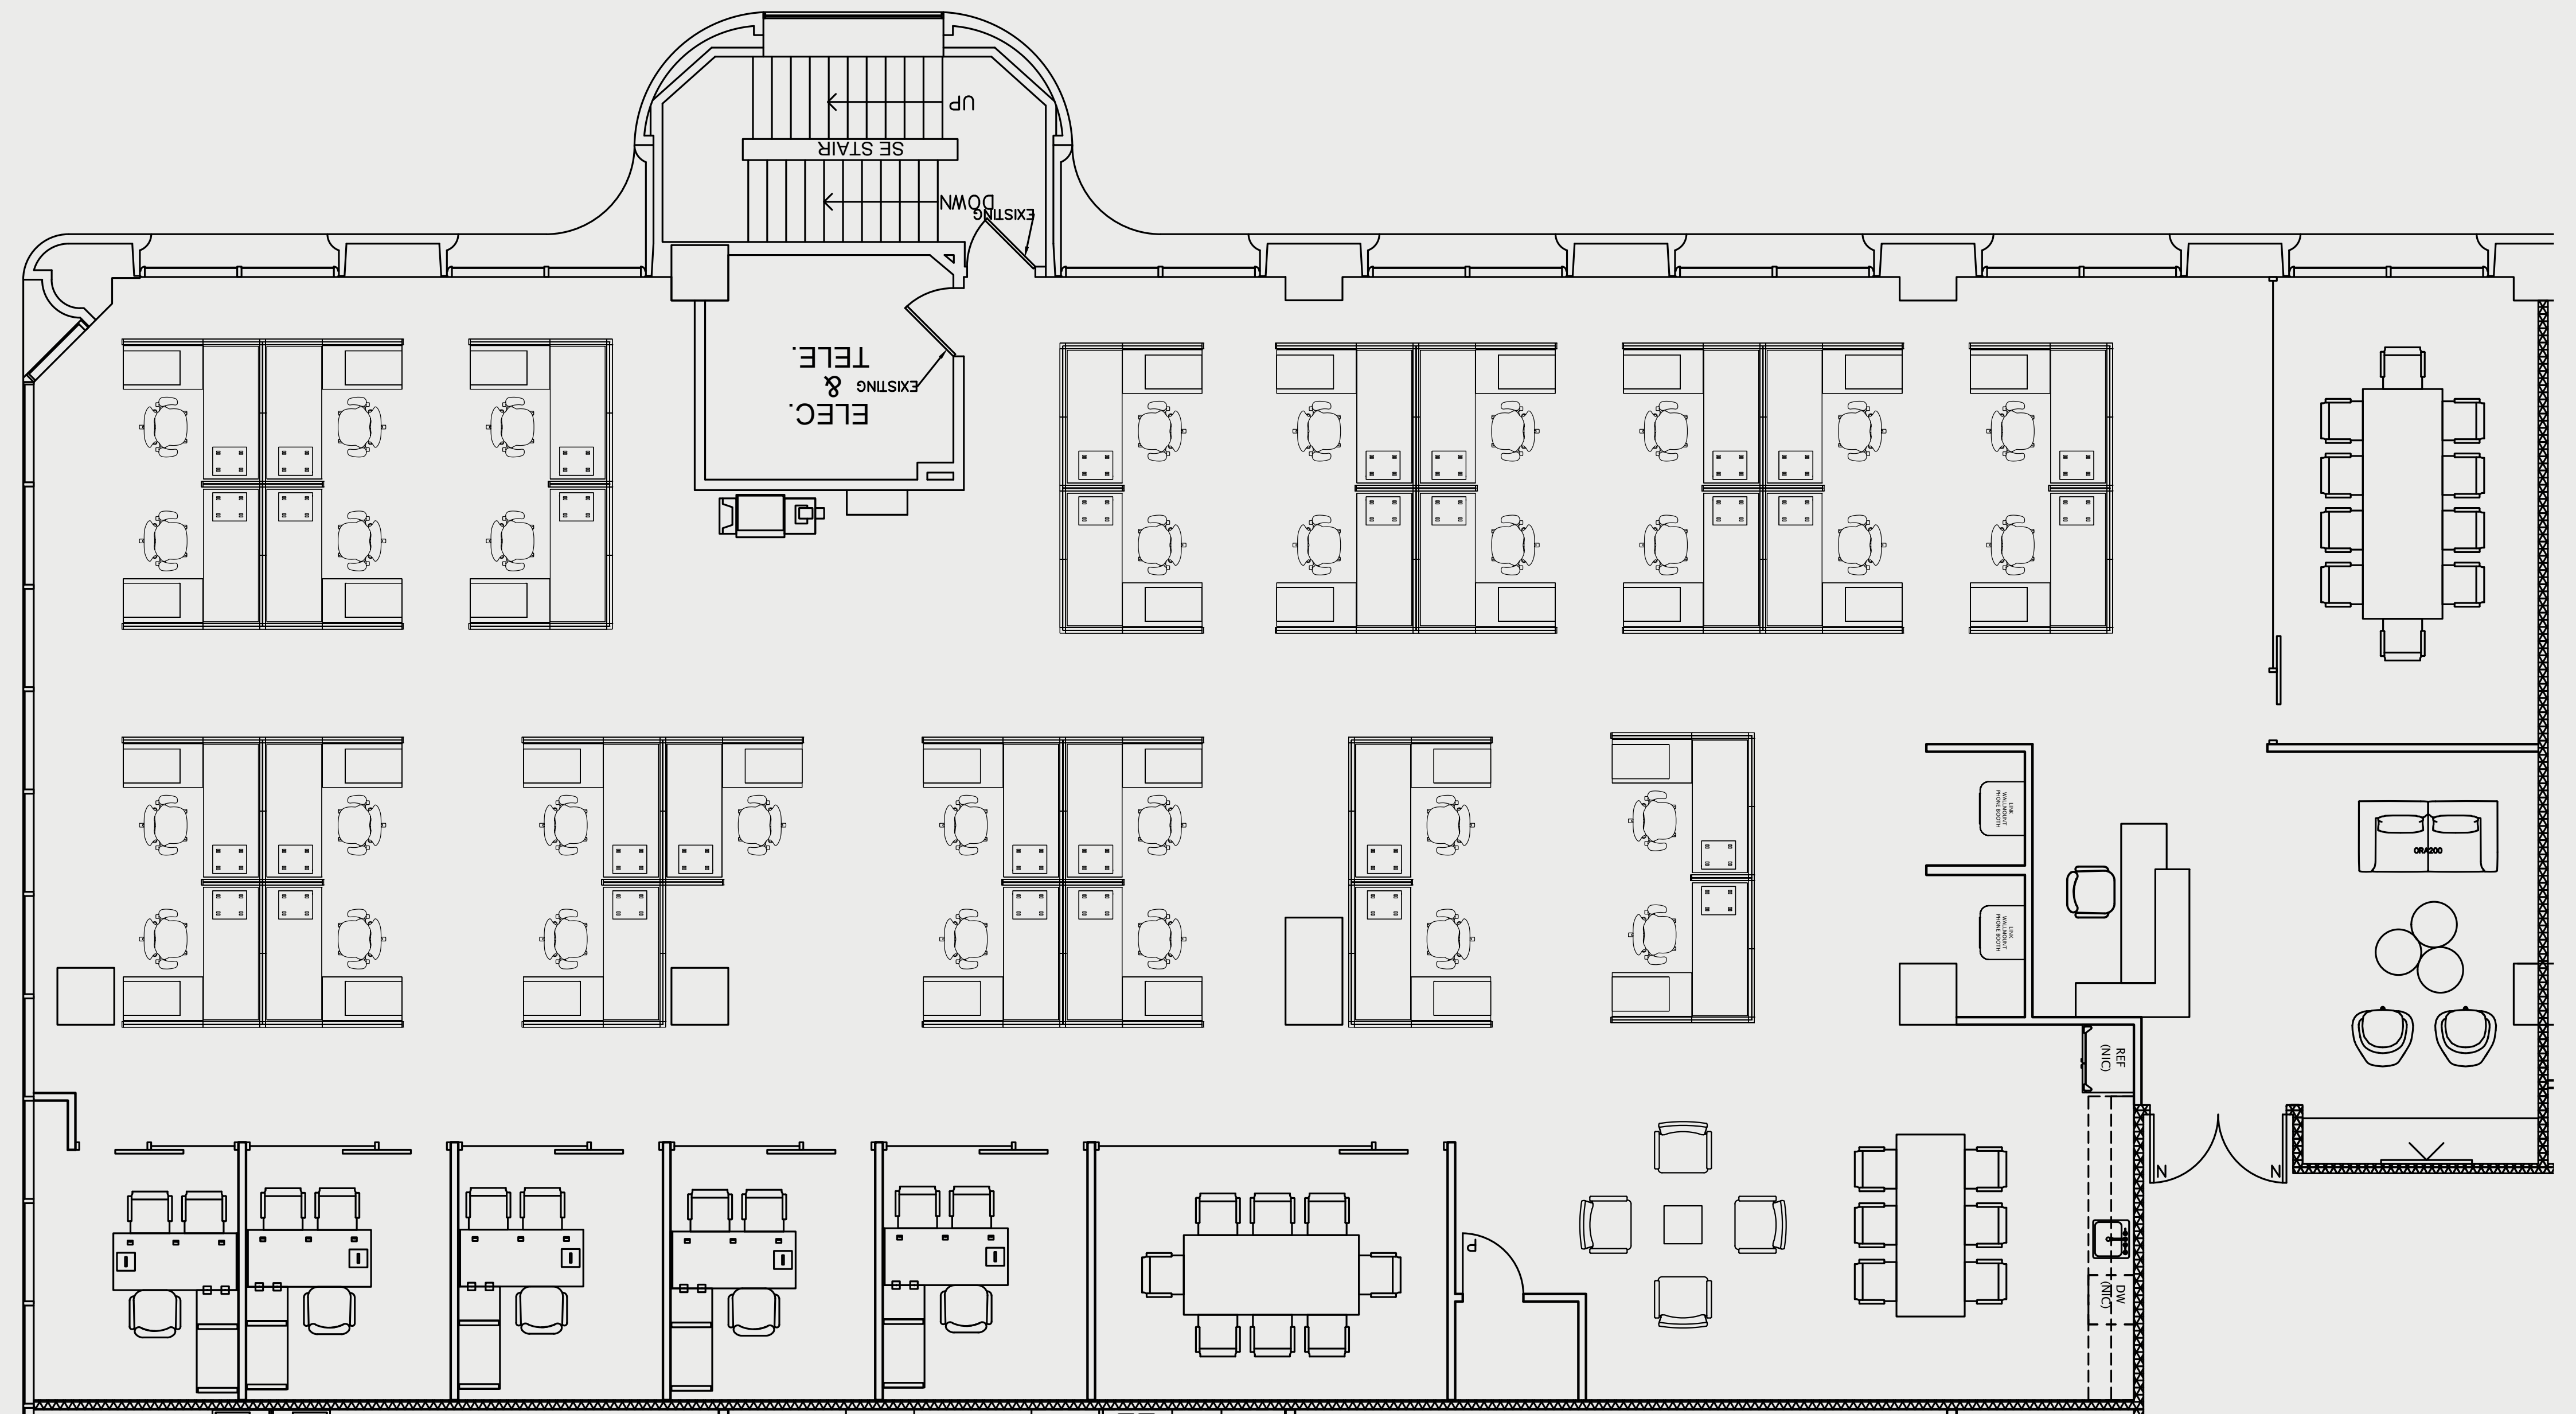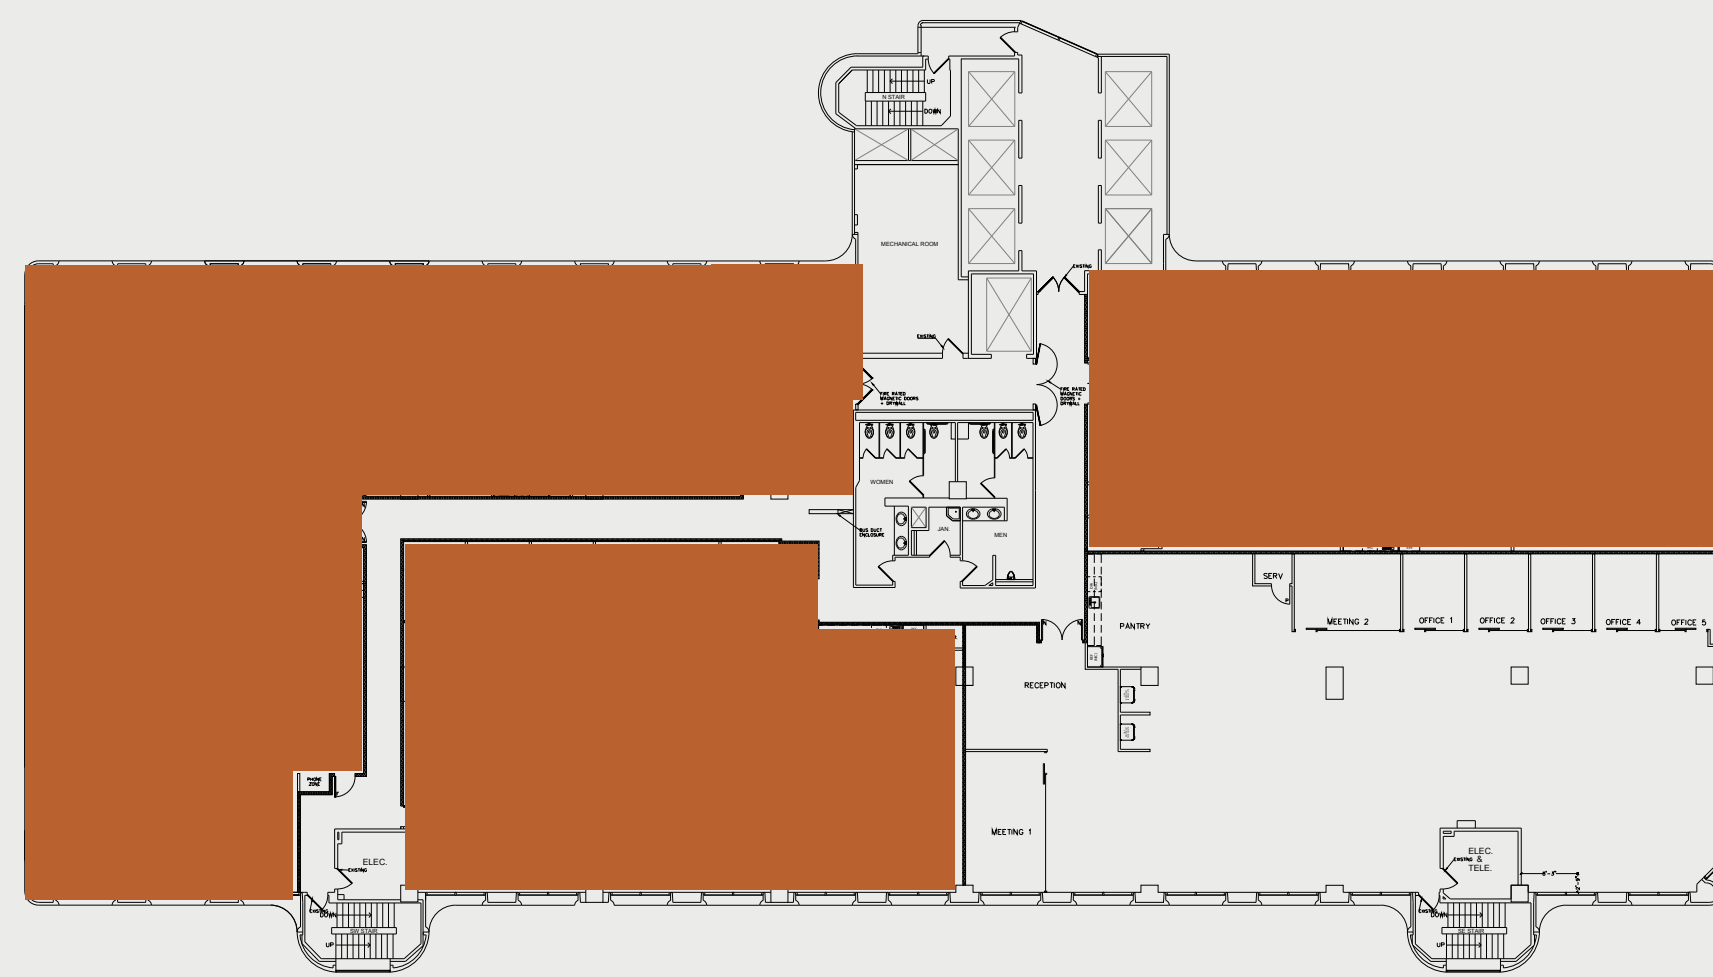

For leasing information please contact:
Scott A. Unger
626.873.1803 | scott.unger@kiddermatthews.com

