

SUITE: 230

RSF: 5,688



611 BRAND

AS-BUILT CONFIGURATION

OFFICES.....	3
RECEPTION.....	1
CONFERENCE ROOMS.....	1
KITCHEN.....	1
OPEN WORK AREA.....	42

Not to scale, furniture and appliances not included

KEY PLAN

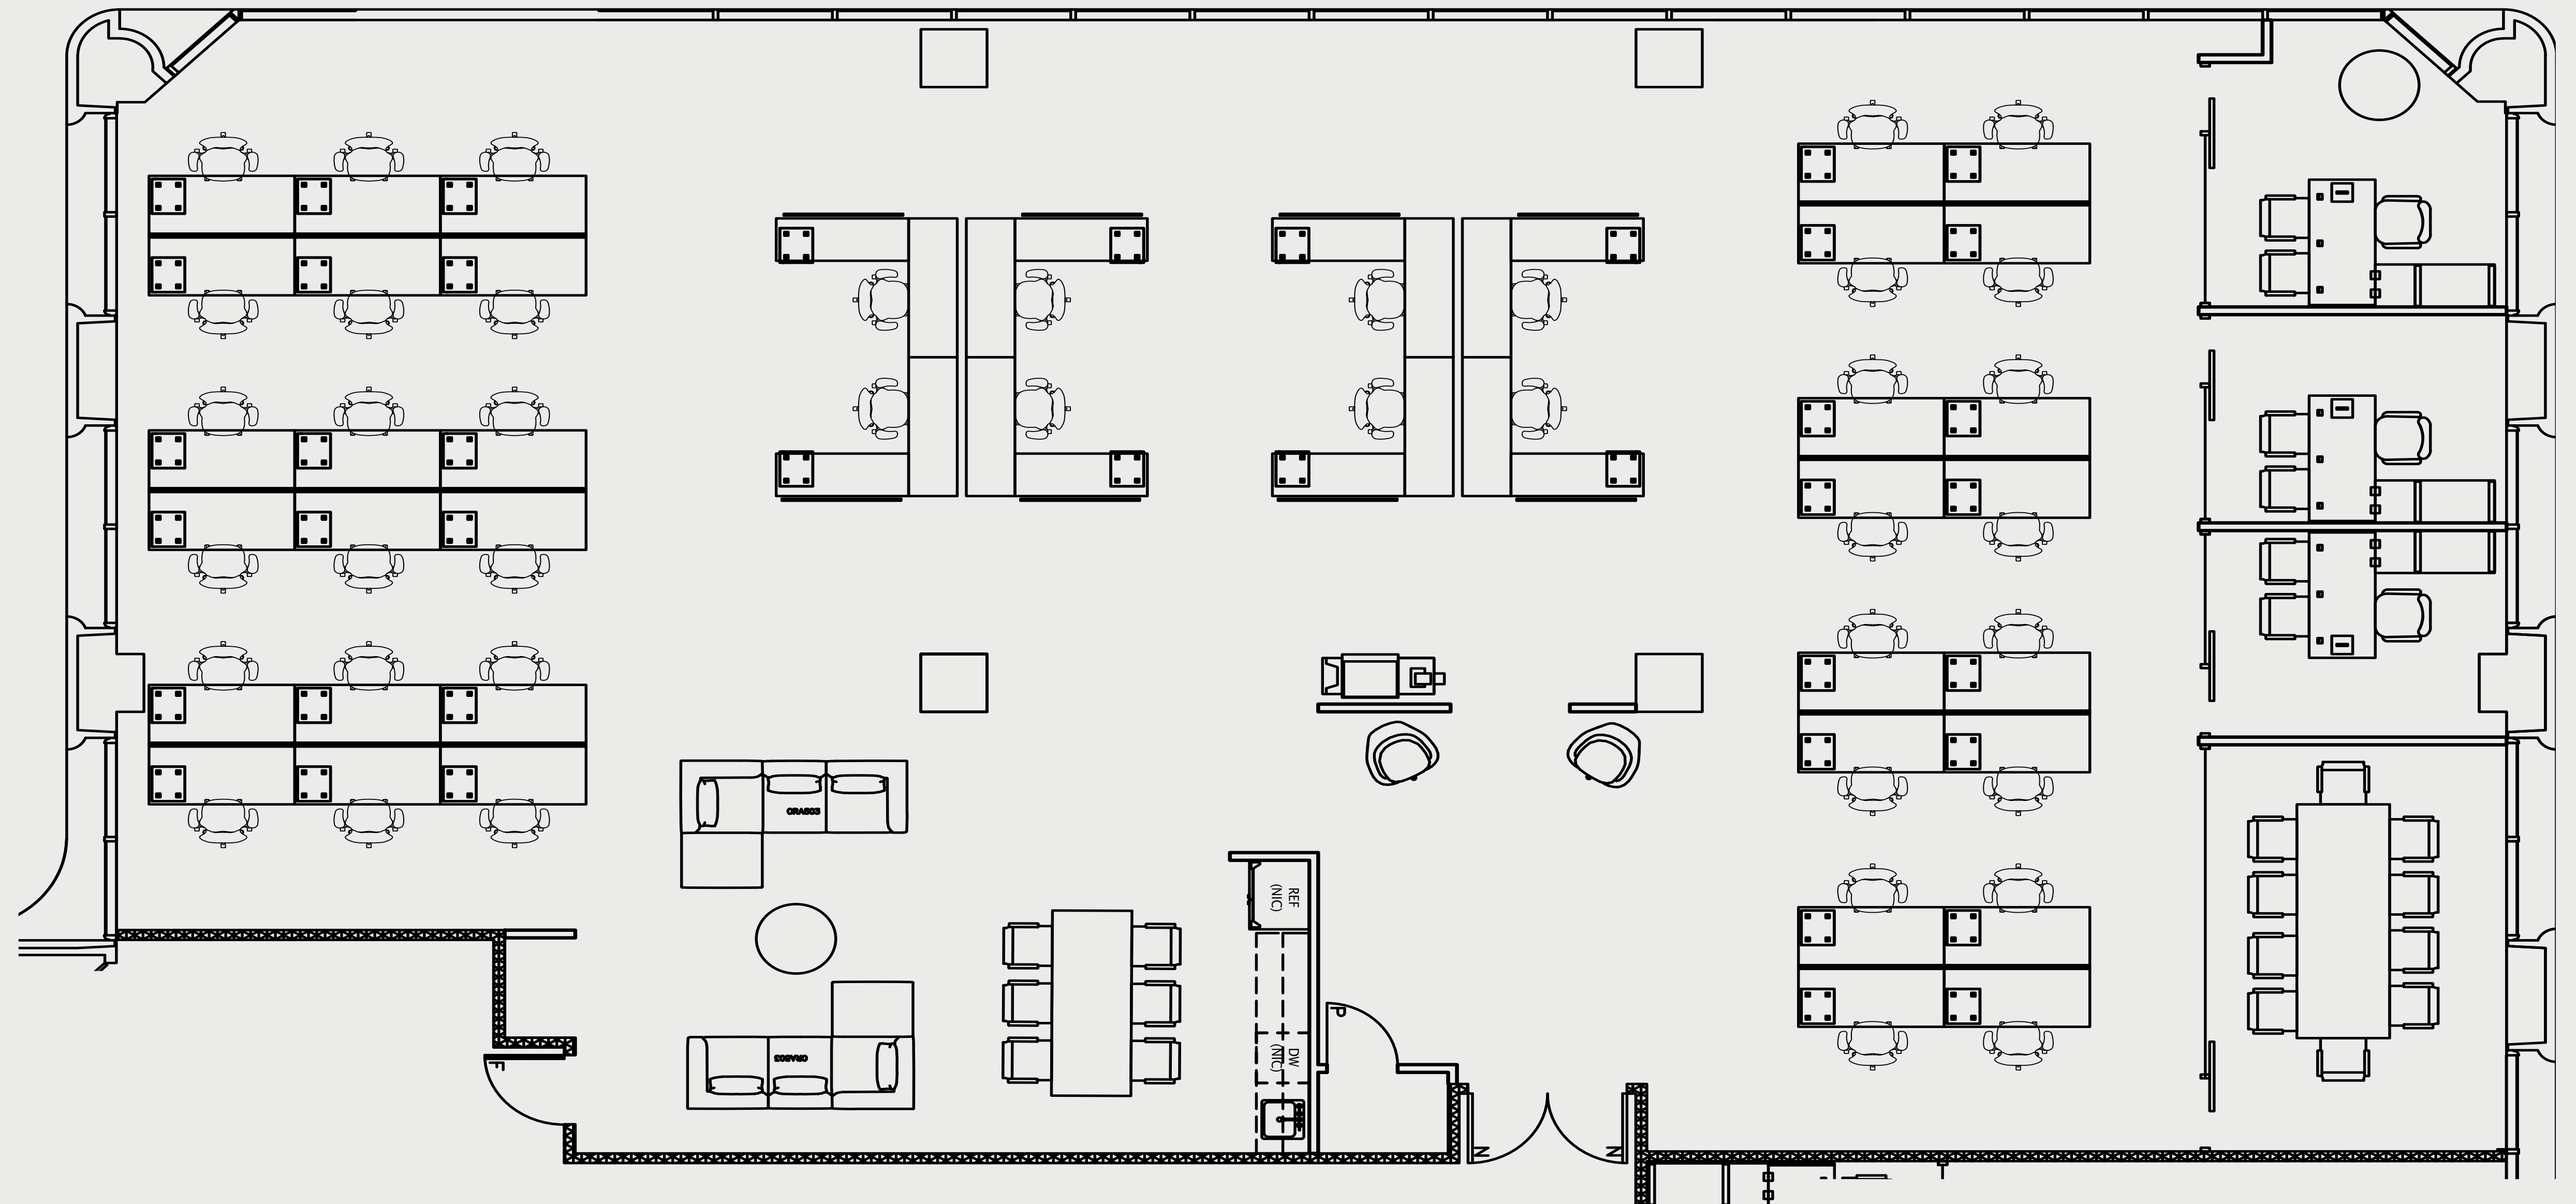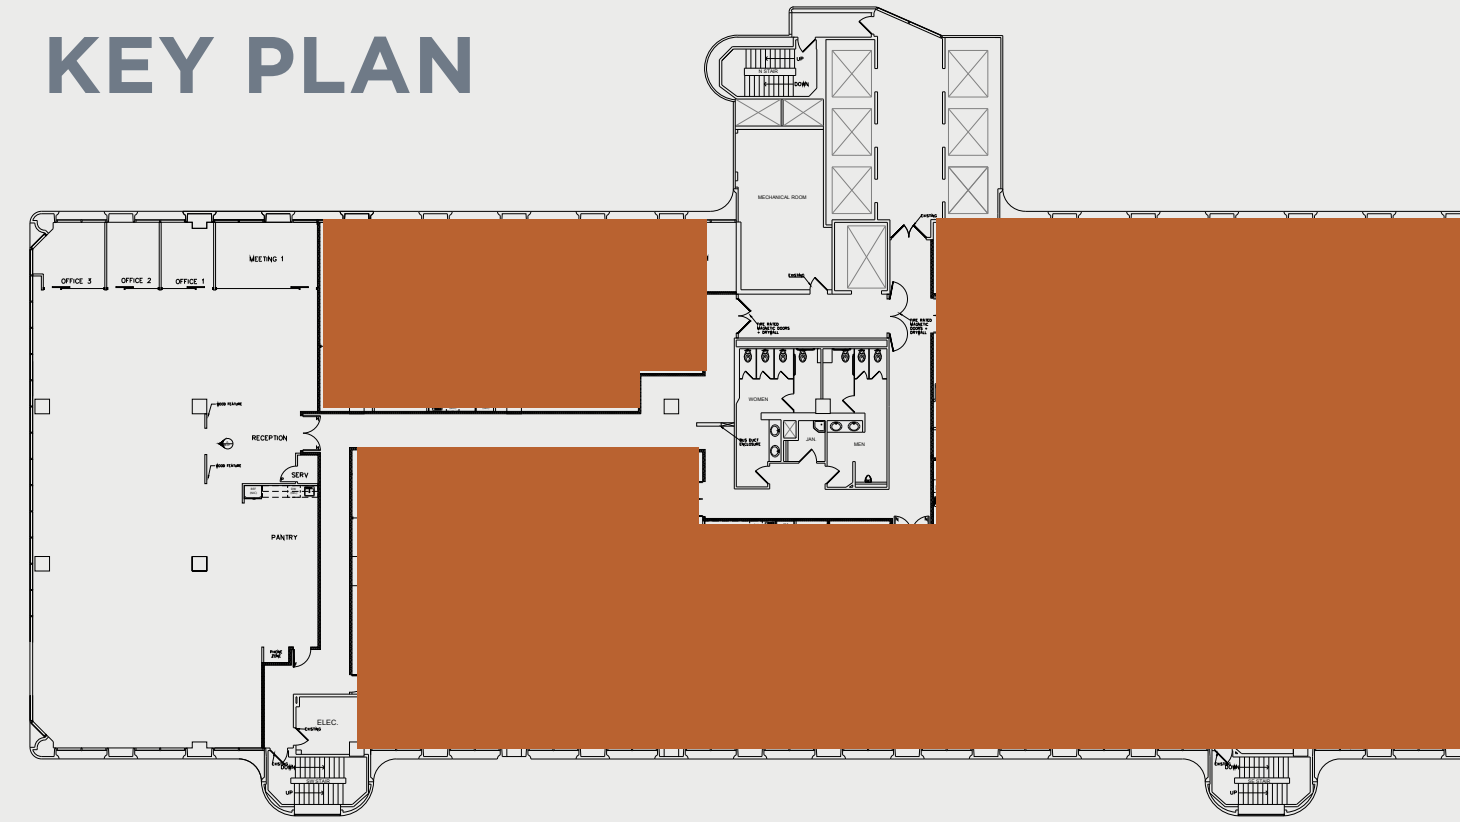

For leasing information please contact:
Scott A. Unger
626.873.1803 | scott.unger@kiddermatthews.com

