


SUITE: 600

RSF: 25,535

611BRAND

AS-BUILT CONFIGURATION

- OFFICES..... 16
- RECEPTION..... 1
- CONFERENCE ROOMS..... 4
- HUDDLE ROOMS..... 5
- PHONE ROOMS.....10
- KITCHEN/BREAKOUT ..... 1
- OPEN WORK AREA.....163+

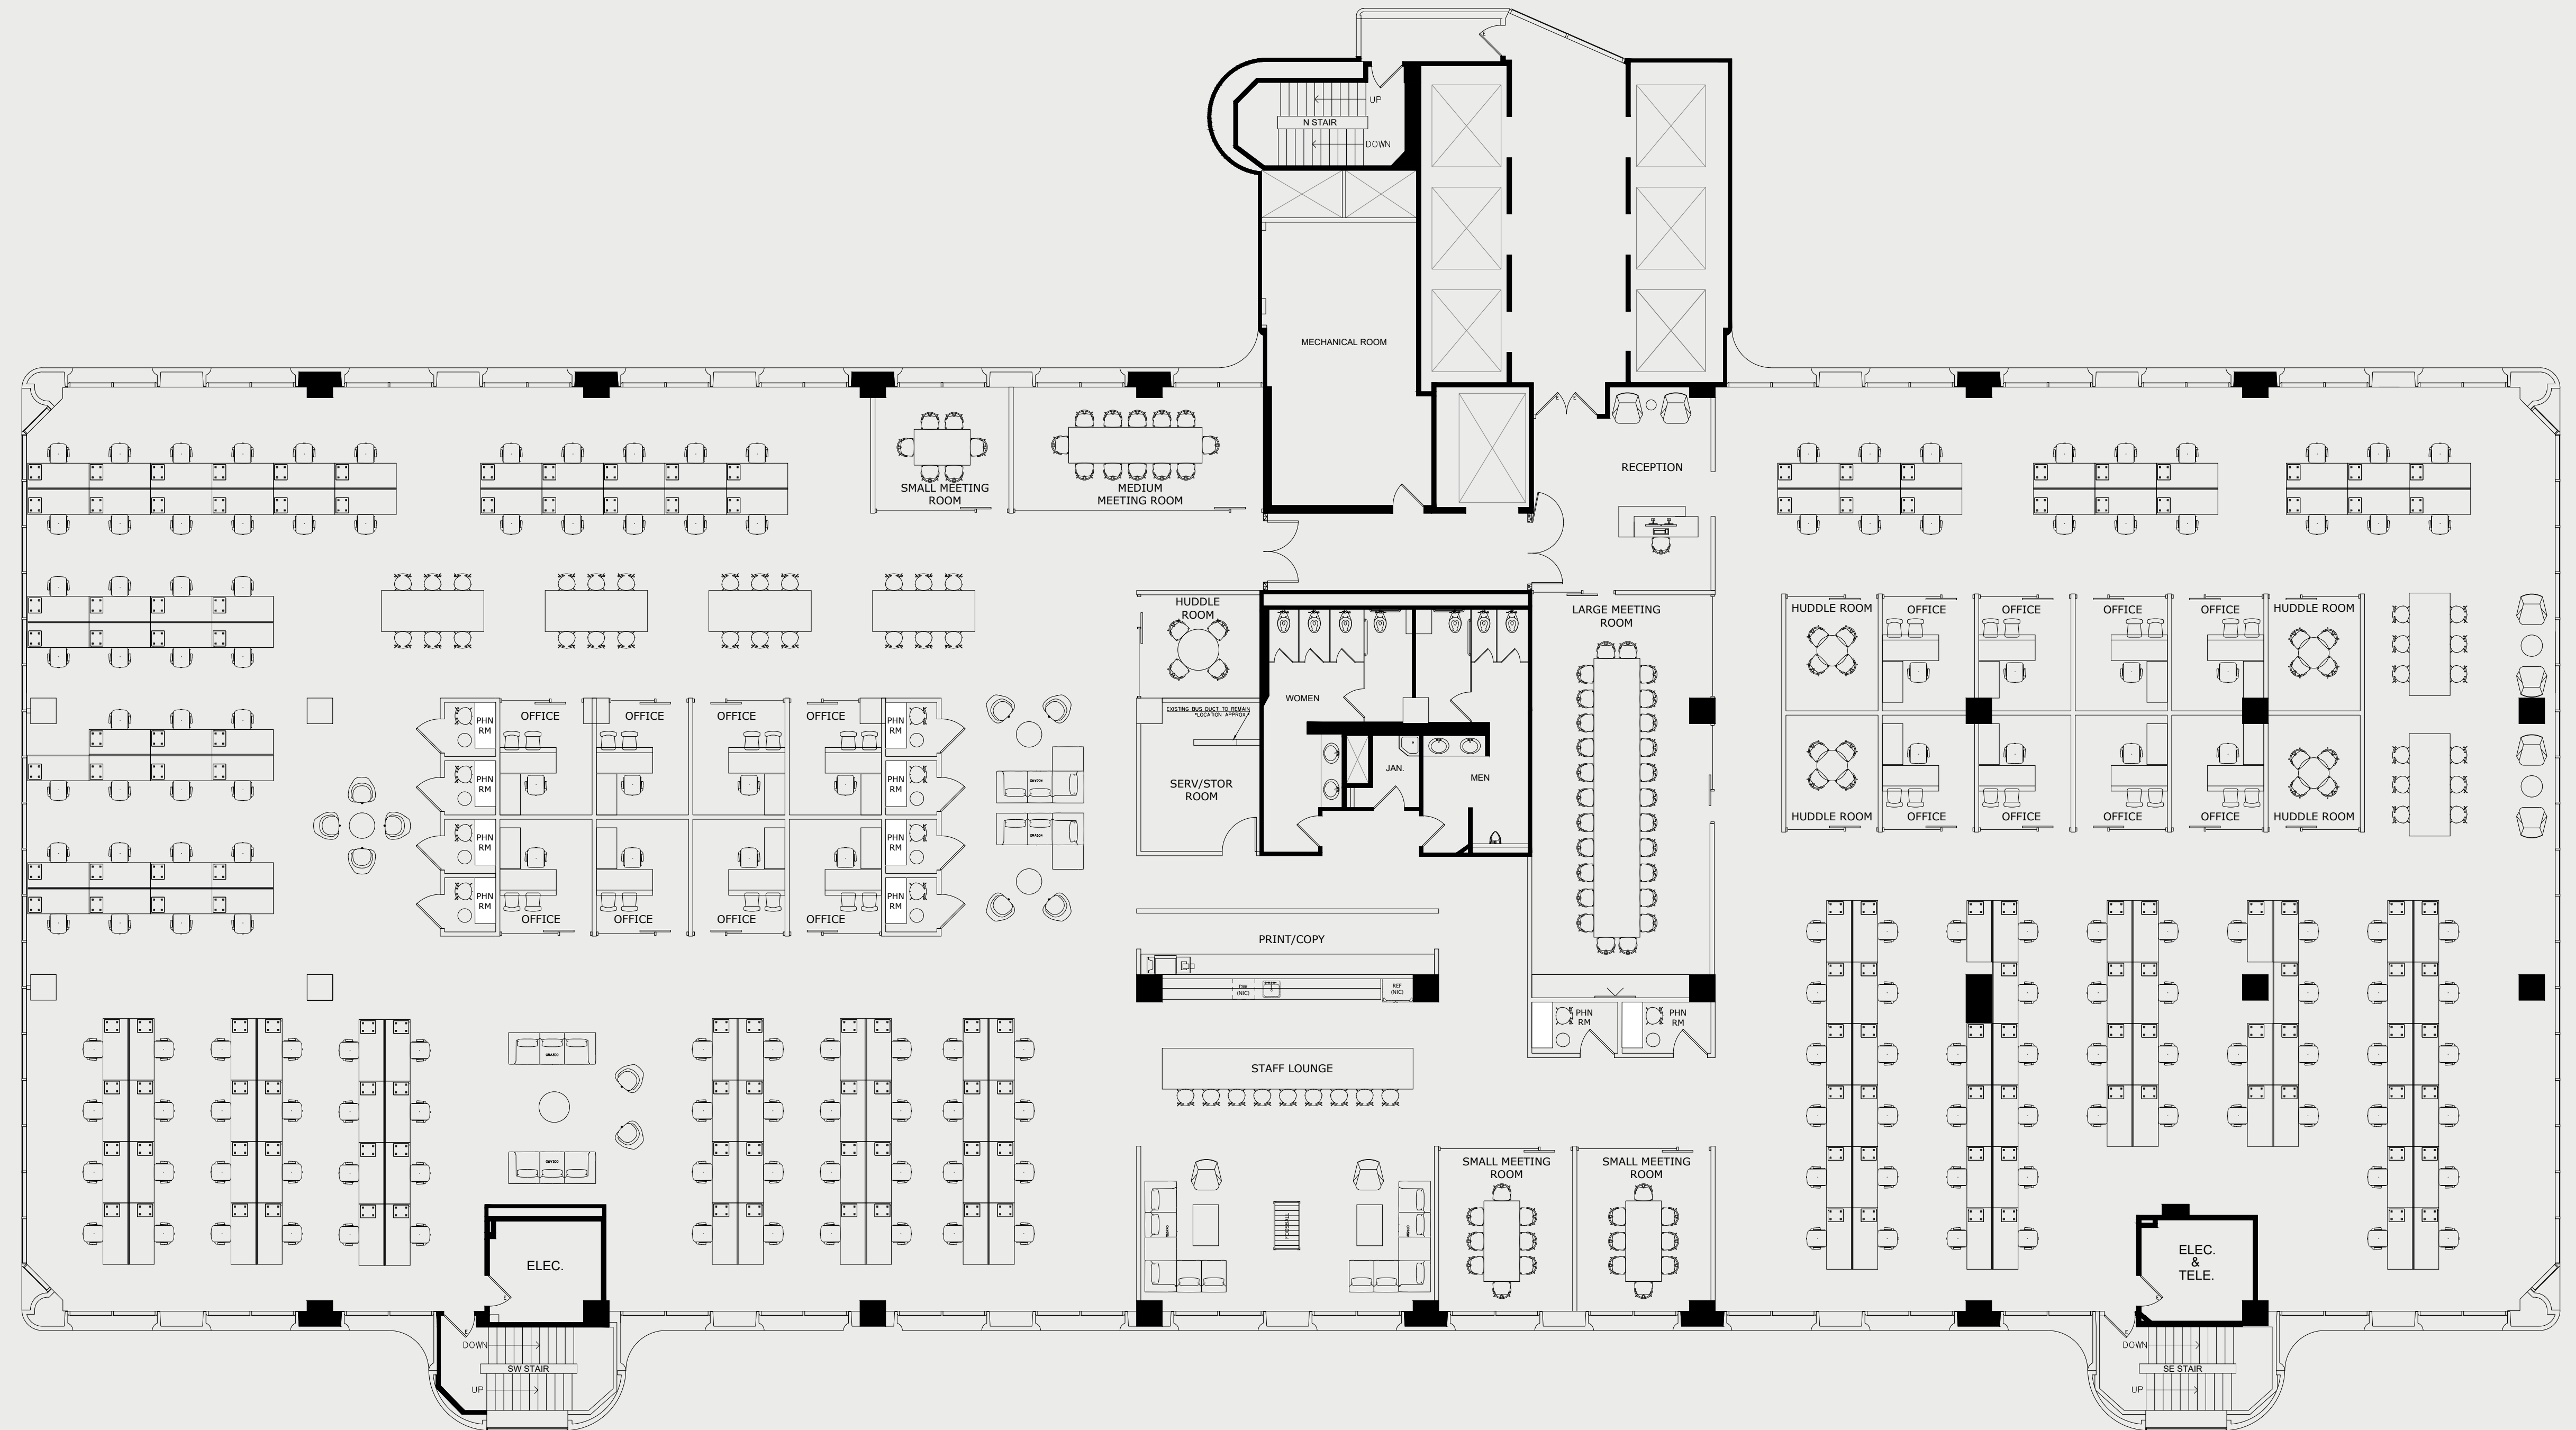

For leasing information please contact:  
Scott A. Unger  
626.873.1803 | [scott.unger@kiddermatthews.com](mailto:scott.unger@kiddermatthews.com).

