


SUITE: 700

RSF: 25,535

611BRAND

AS-BUILT CONFIGURATION

- OFFICES..... 16
- RECEPTION..... 1
- CONFERENCE ROOMS..... 4
- HUDDLE ROOMS..... 5
- PHONE ROOMS.....10
- KITCHEN/BREAKOUT 1
- OPEN WORK AREA.....163+

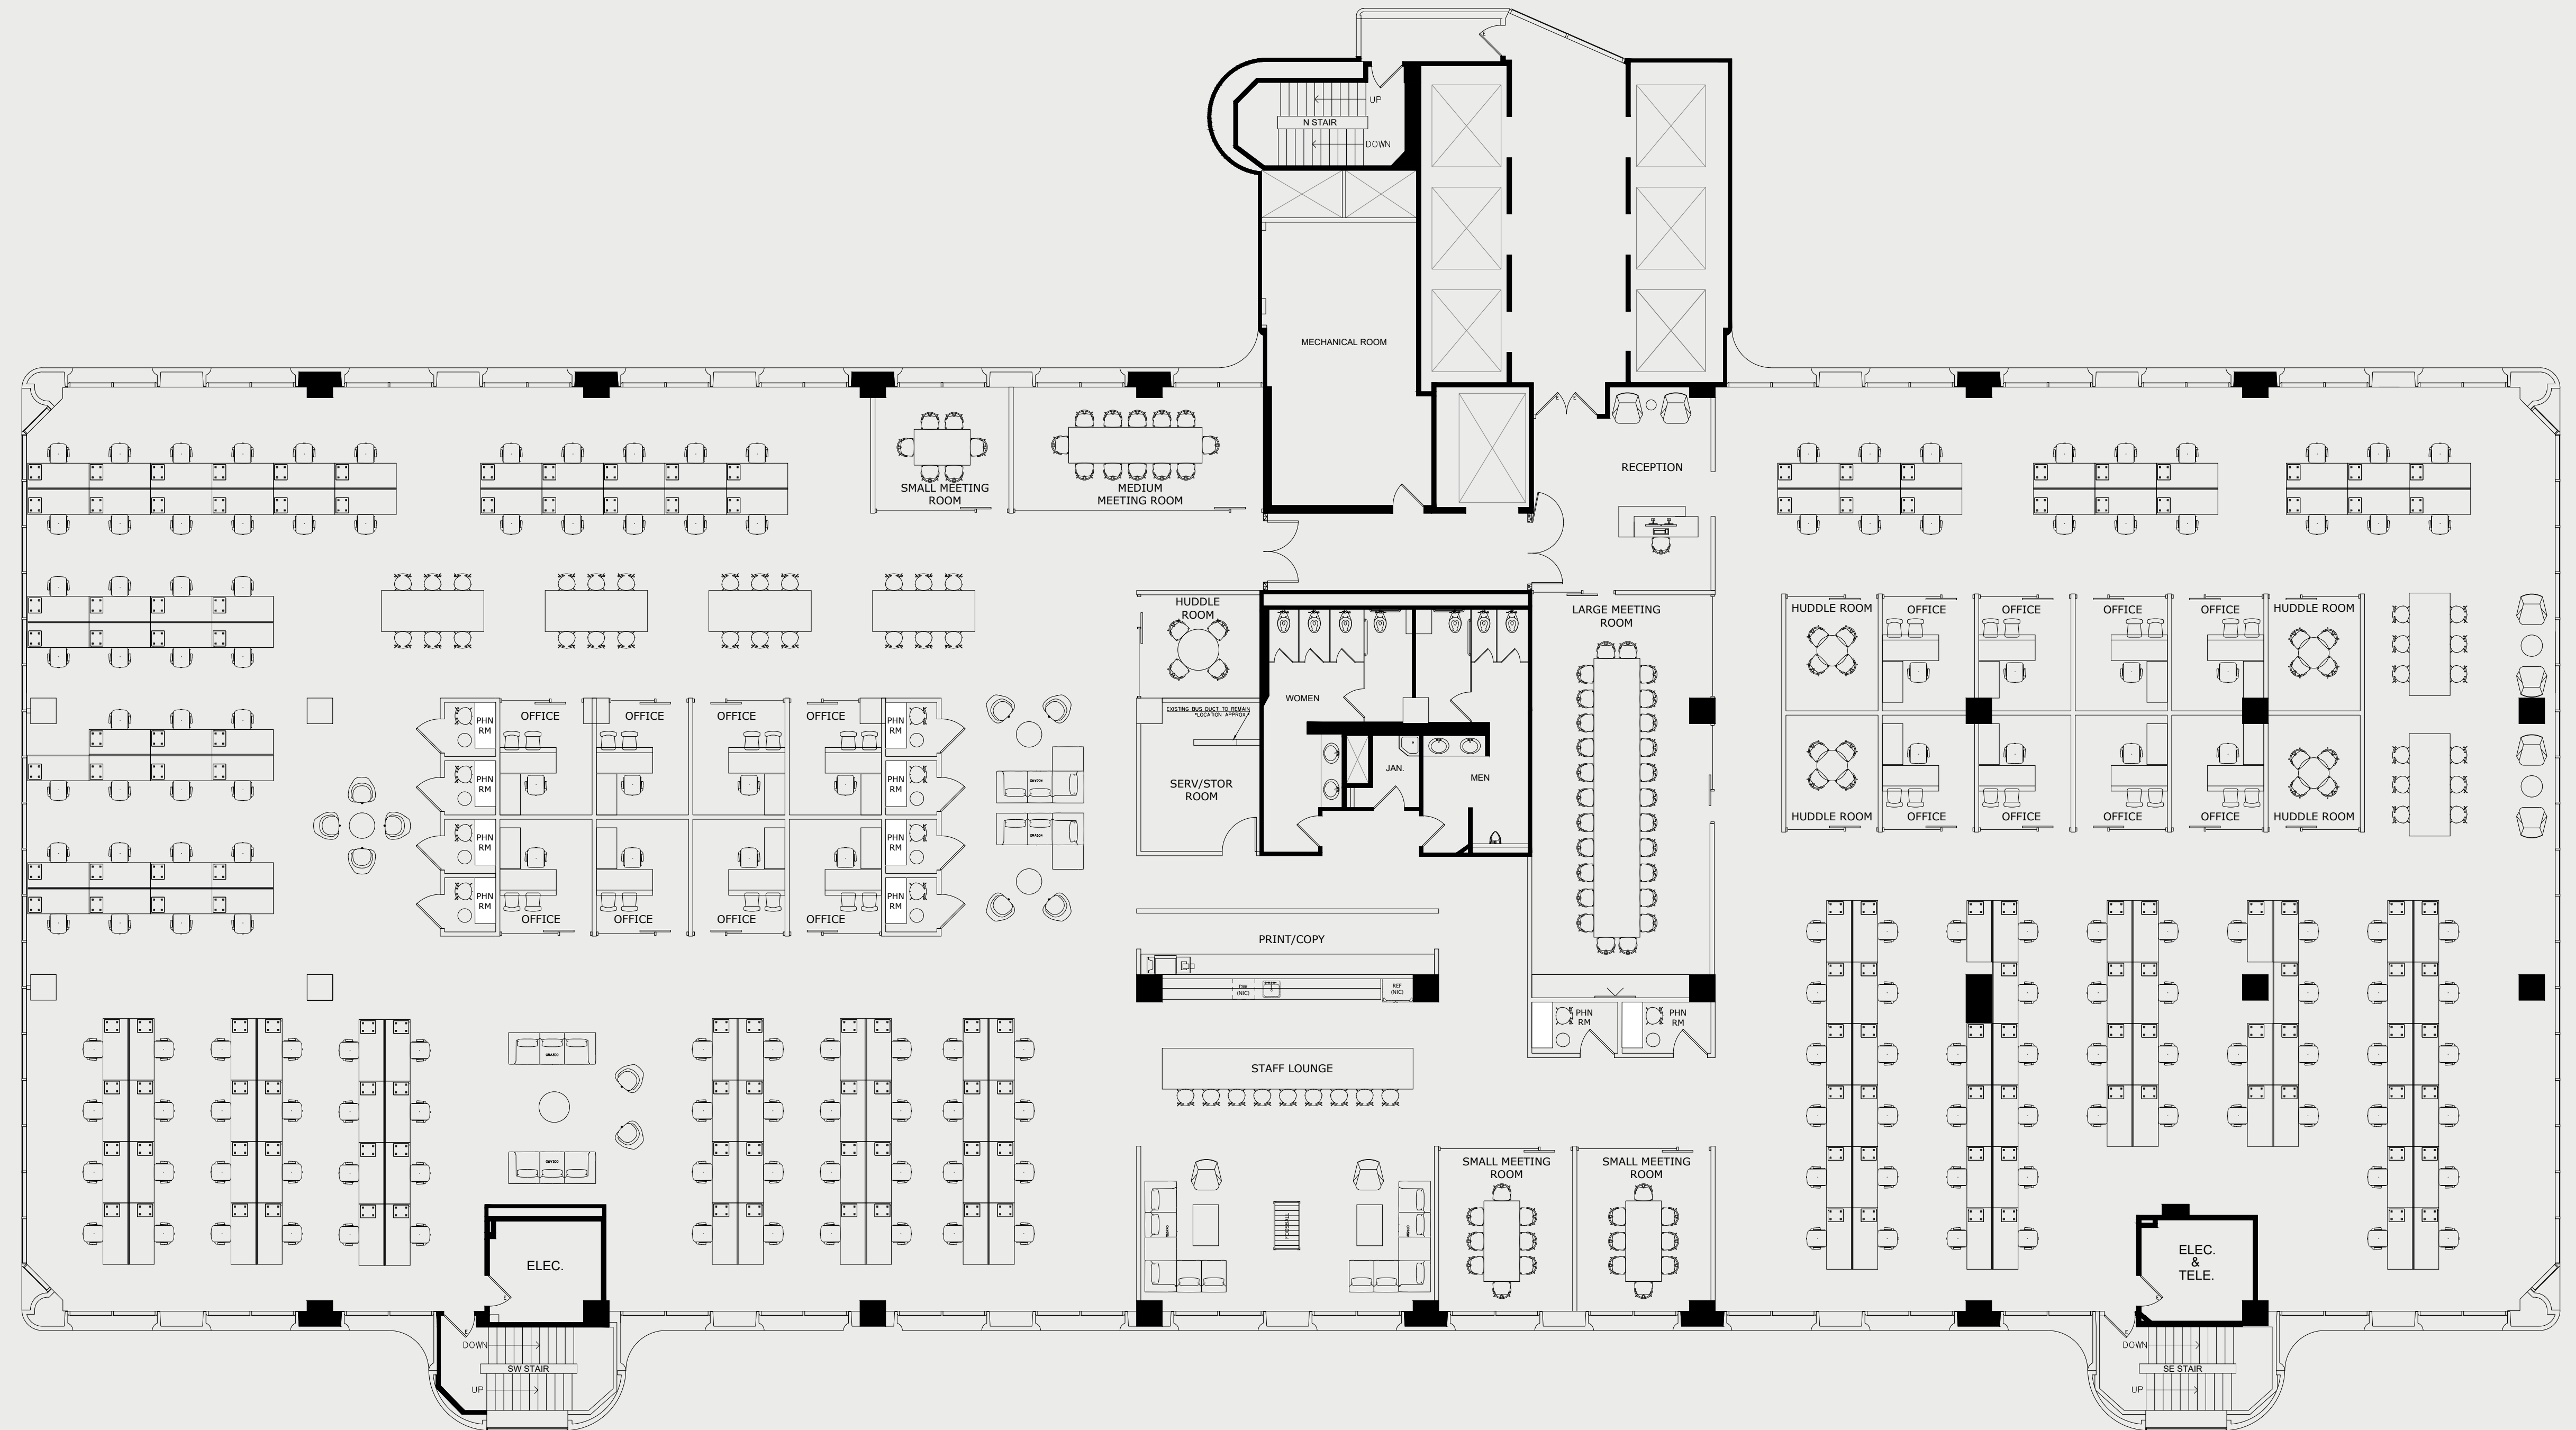

For leasing information please contact:
Scott A. Unger
626.873.1803 | scott.unger@kiddermatthews.com

