

SUITE: 1100

RSF: 25,410



611 BRAND

AS-BUILT CONFIGURATION

OFFICES.....	14
RECEPTION.....	1
CONFERENCE ROOMS.....	10
KITCHEN.....	2
OPEN WORK AREA.....	+/- 127

Not to scale, furniture and appliances not included

KEY PLAN

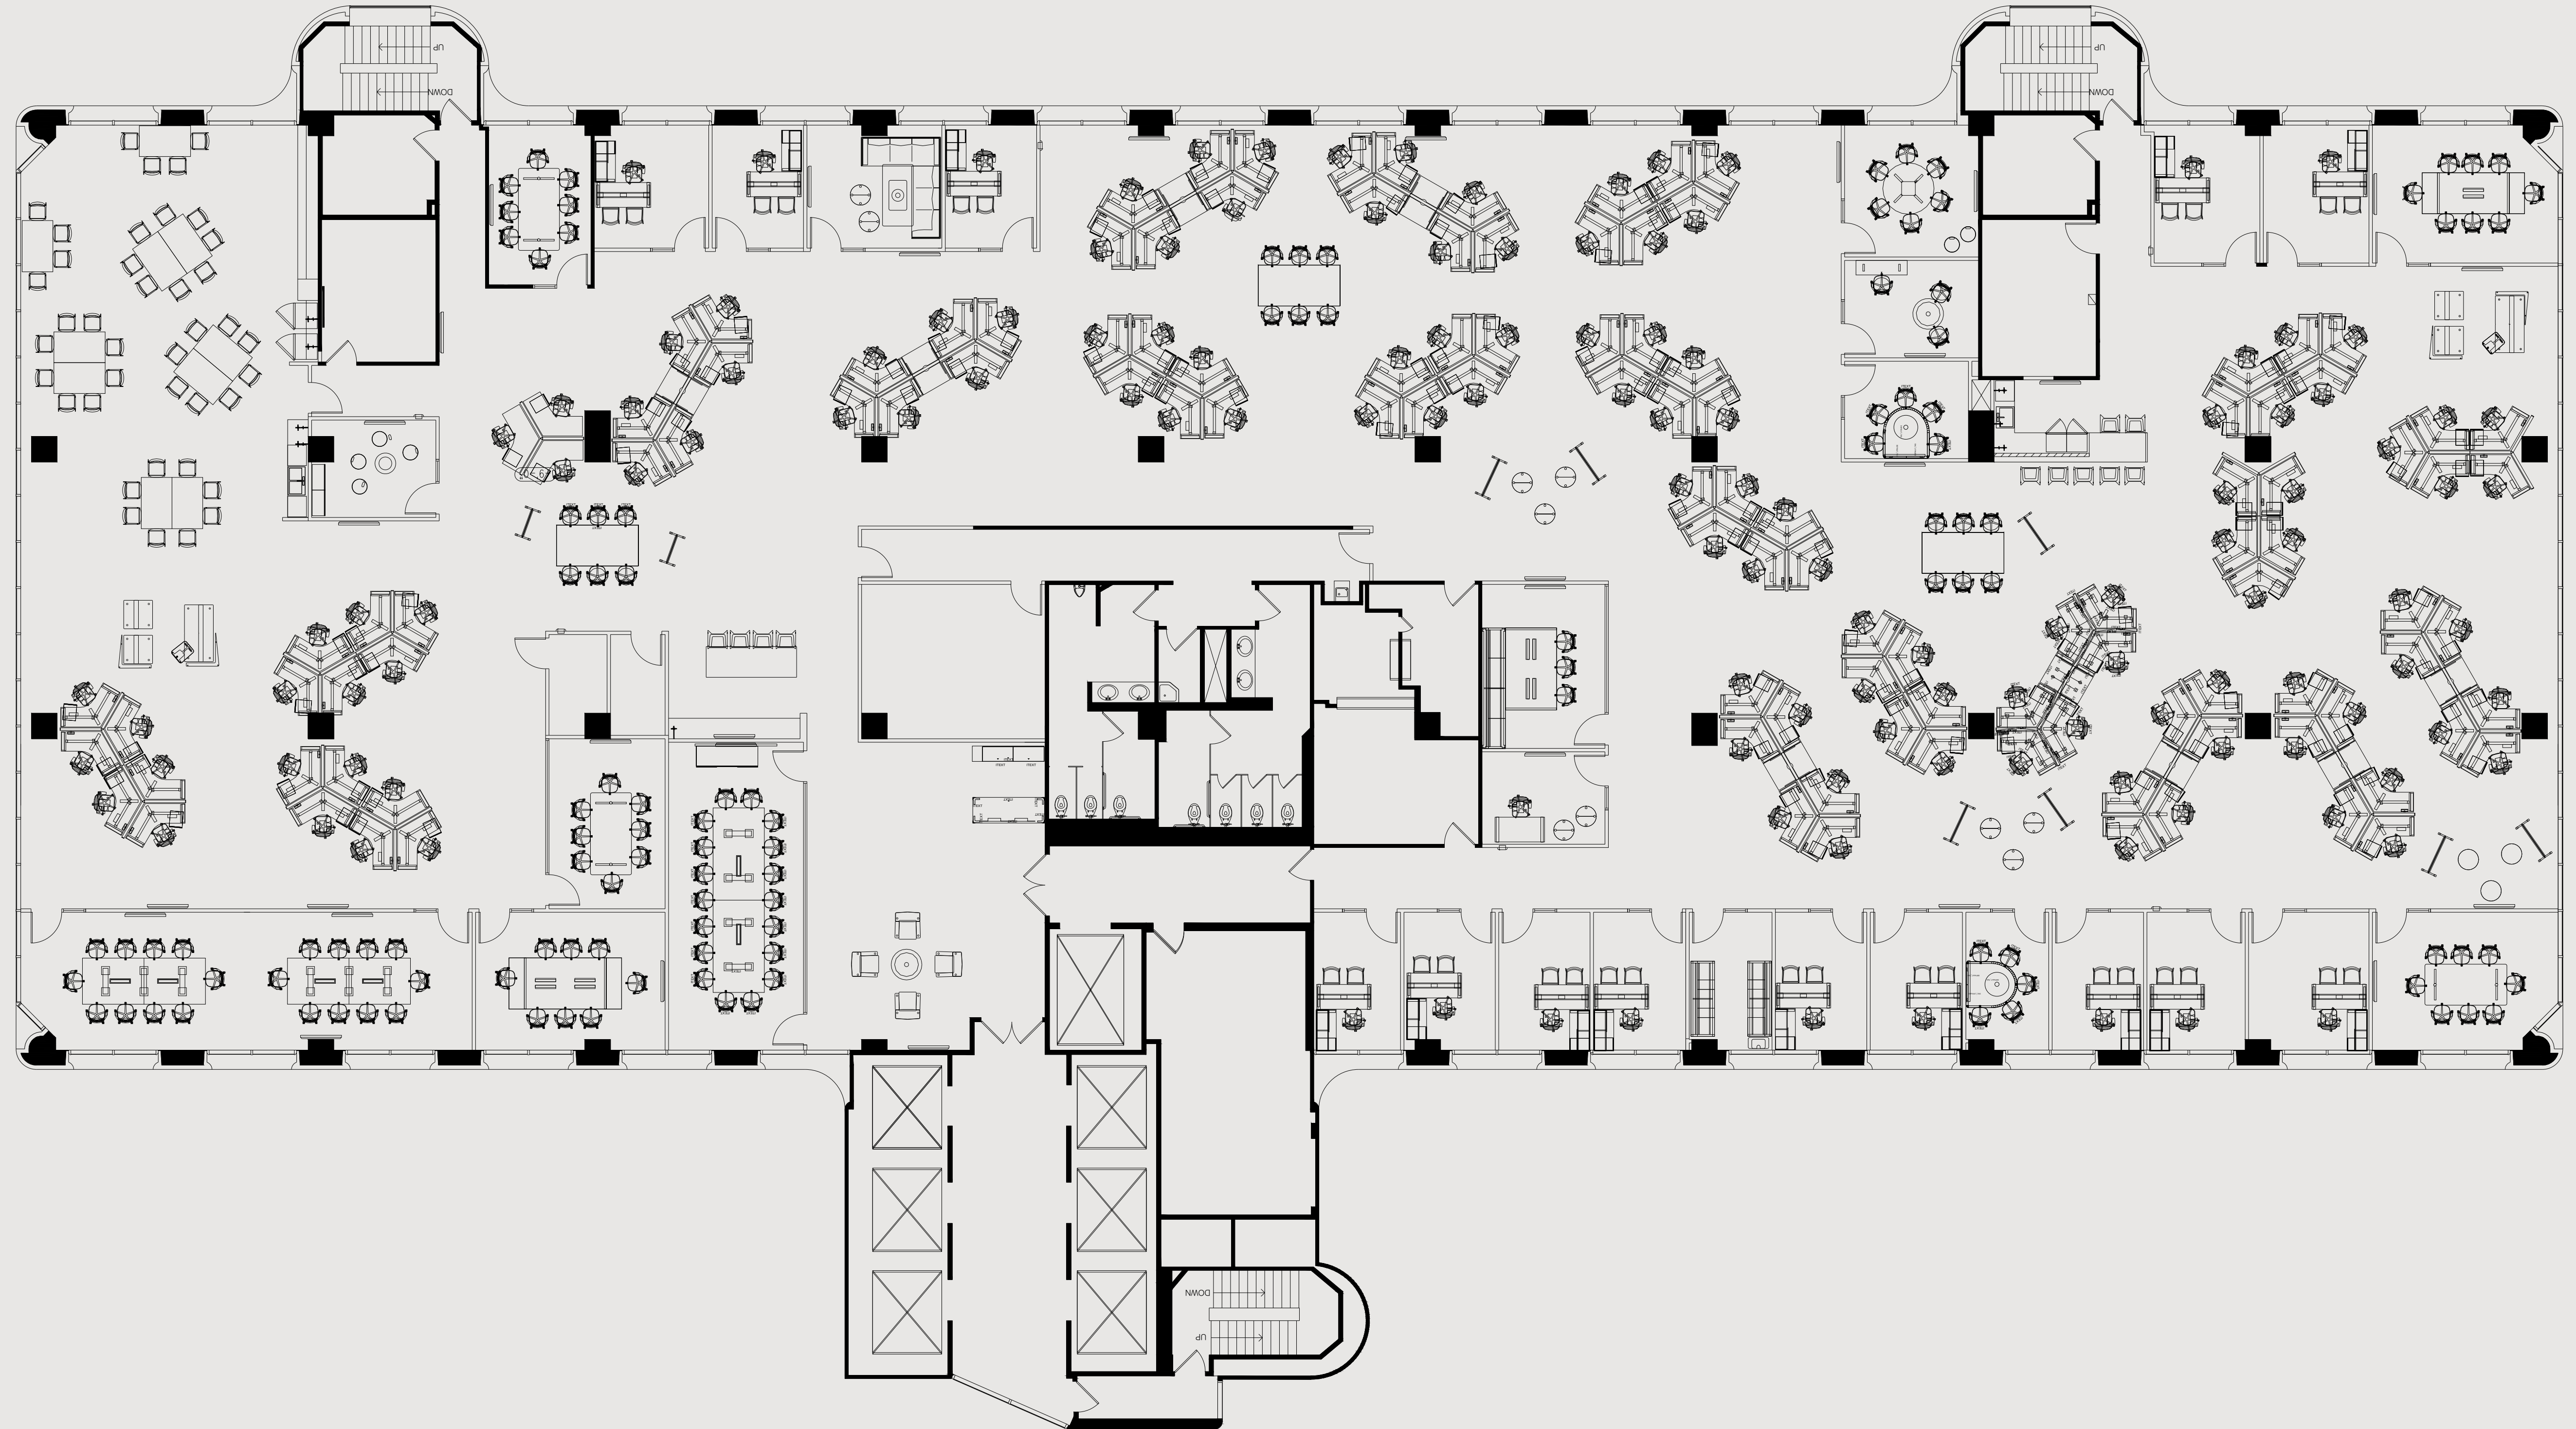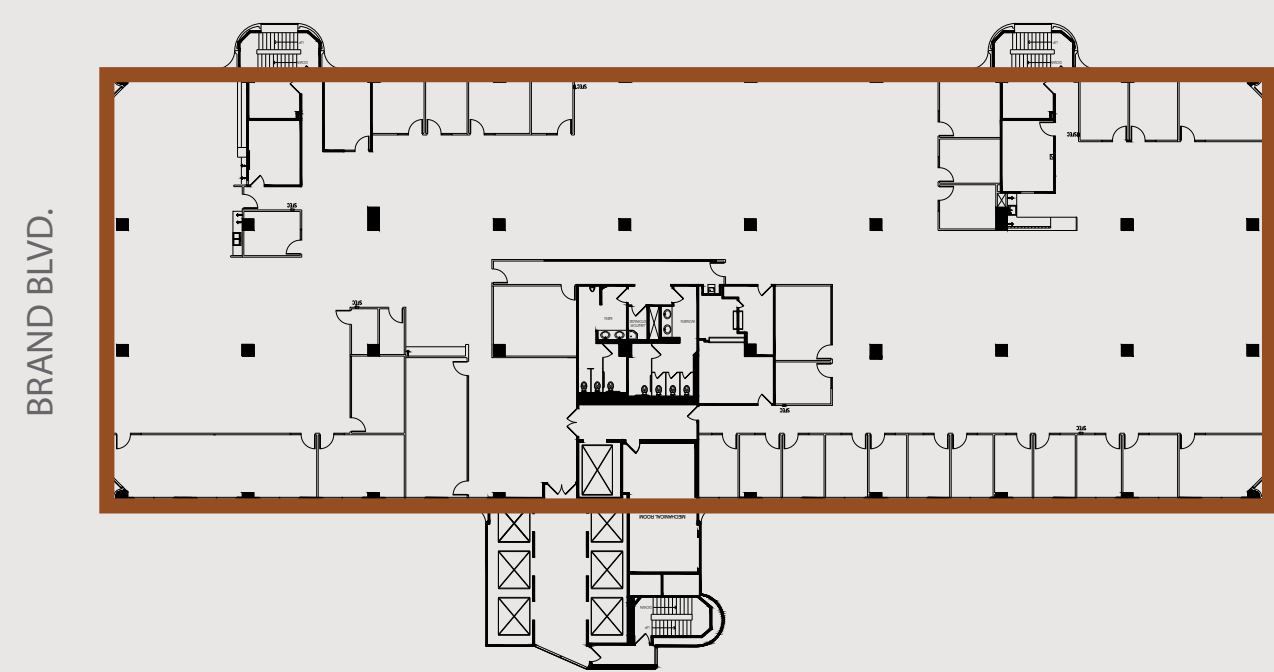

For leasing information please contact:
Scott A. Unger
626.873.1803 | scott.unger@kidder.com

