

SUITE: 1100

RSF: 7,396



611BRAND

AS-BUILT CONFIGURATION

OFFICES.....	N/A
RECEPTION.....	1
CONFERENCE ROOMS.....	4
KITCHEN.....	1
OPEN WORK AREA.....	+/- 22

Not to scale, furniture and appliances not included

KEY PLAN

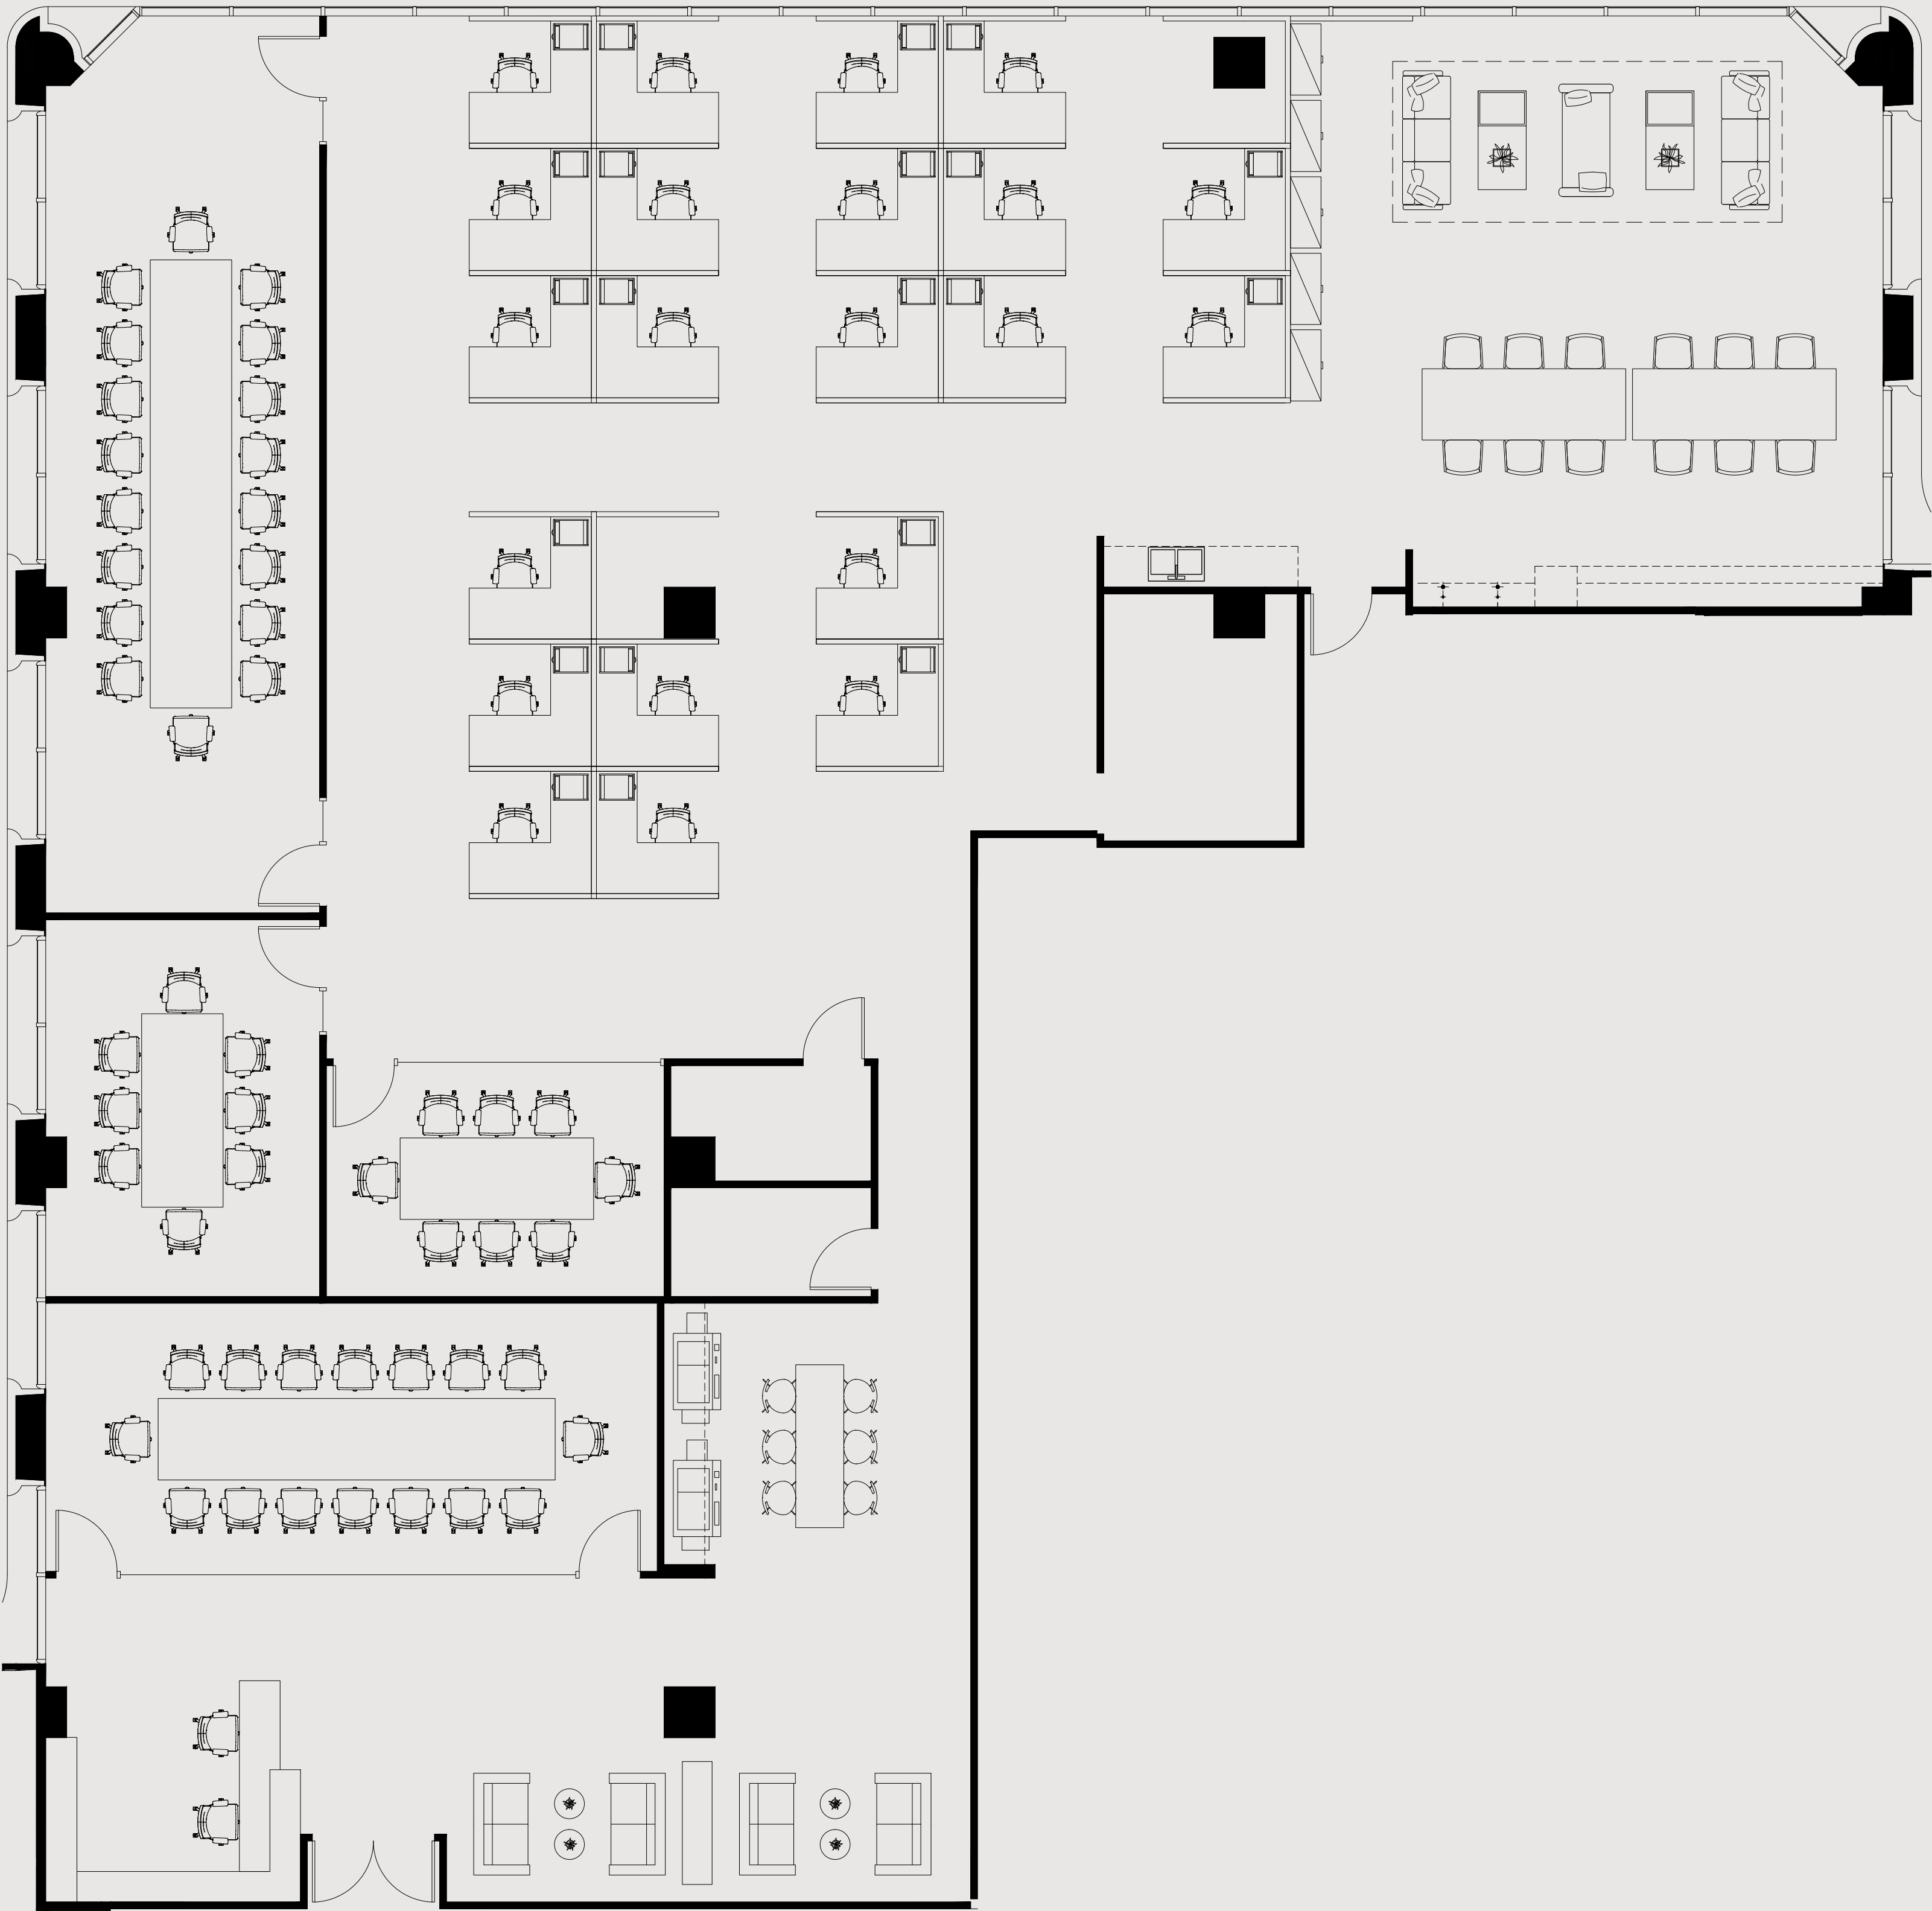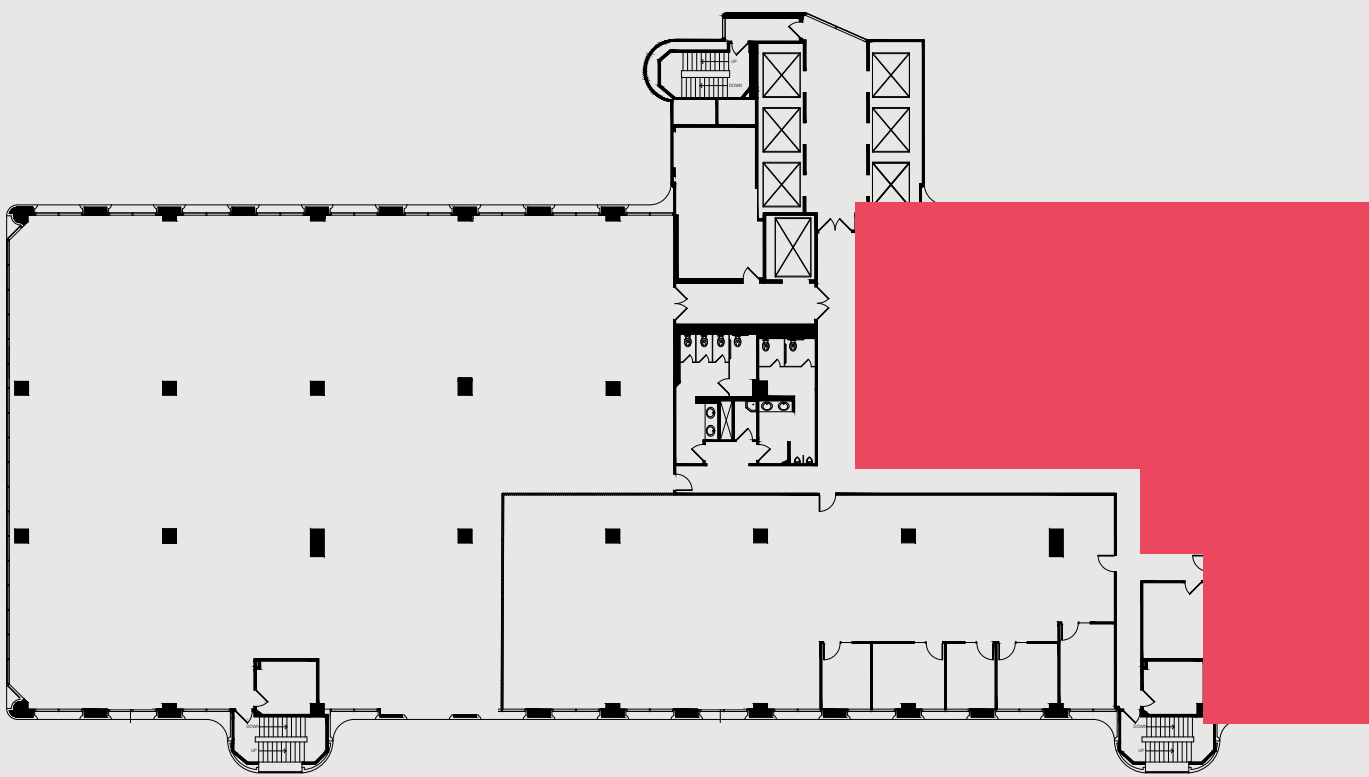

For leasing information please contact:
USALEASING@ONNI.COM
(213) 629-2041

