

SUITE: 230

RSF: 5,634


611BRAND

AS-BUILT CONFIGURATION

OFFICES.....	3
RECEPTION.....	1
CONFERENCE ROOMS.....	1
KITCHEN.....	1
OPEN WORK AREA.....	+/- 36

Not to scale, furniture and appliances not included

KEY PLAN

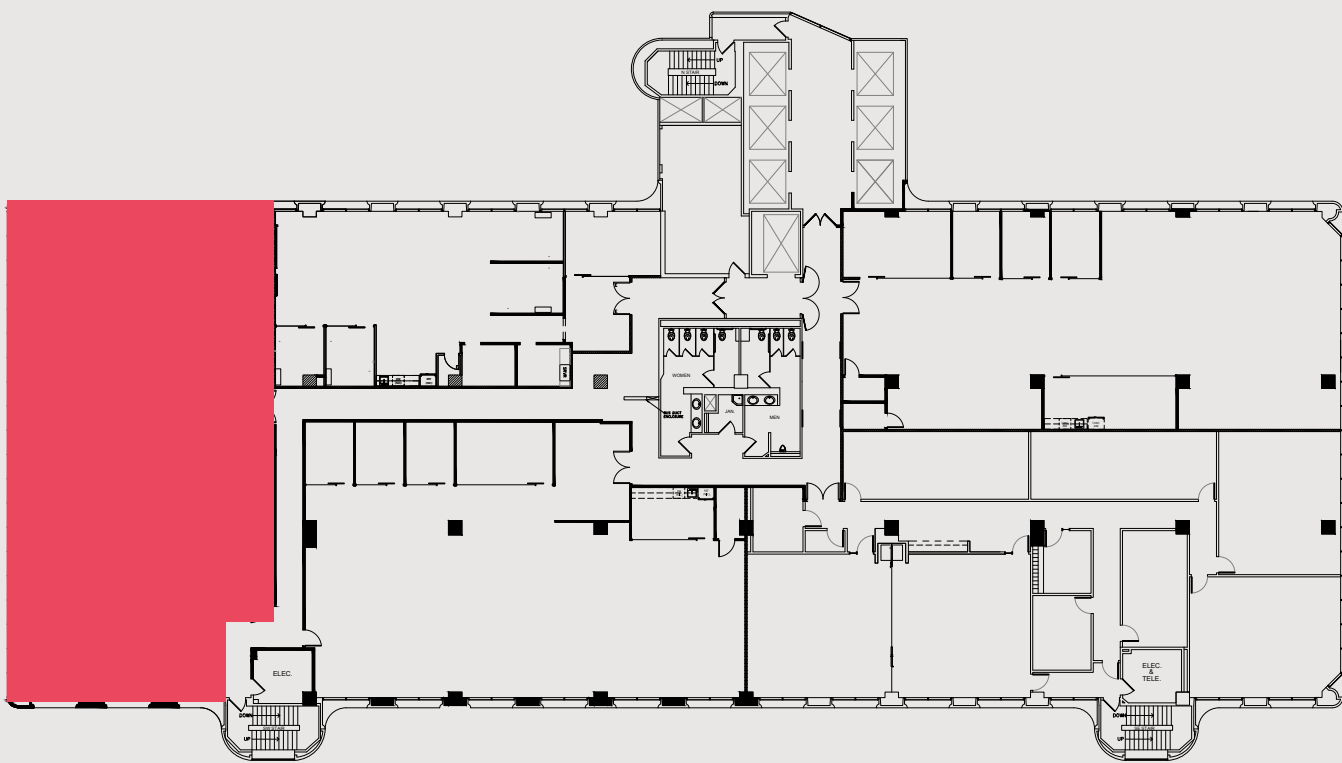

For leasing information please contact:

USALEASING@ONNI.COM
(213) 629-2041

