

SUITE: 400

RSF: 25,424



611BRAND

AS-BUILT CONFIGURATION

OFFICES.....	5
RECEPTION.....	1
CONFERENCE ROOMS.....	5
KITCHEN.....	2
OPEN WORK AREA.....	+/- 188

Not to scale, furniture and appliances not included

KEY PLAN

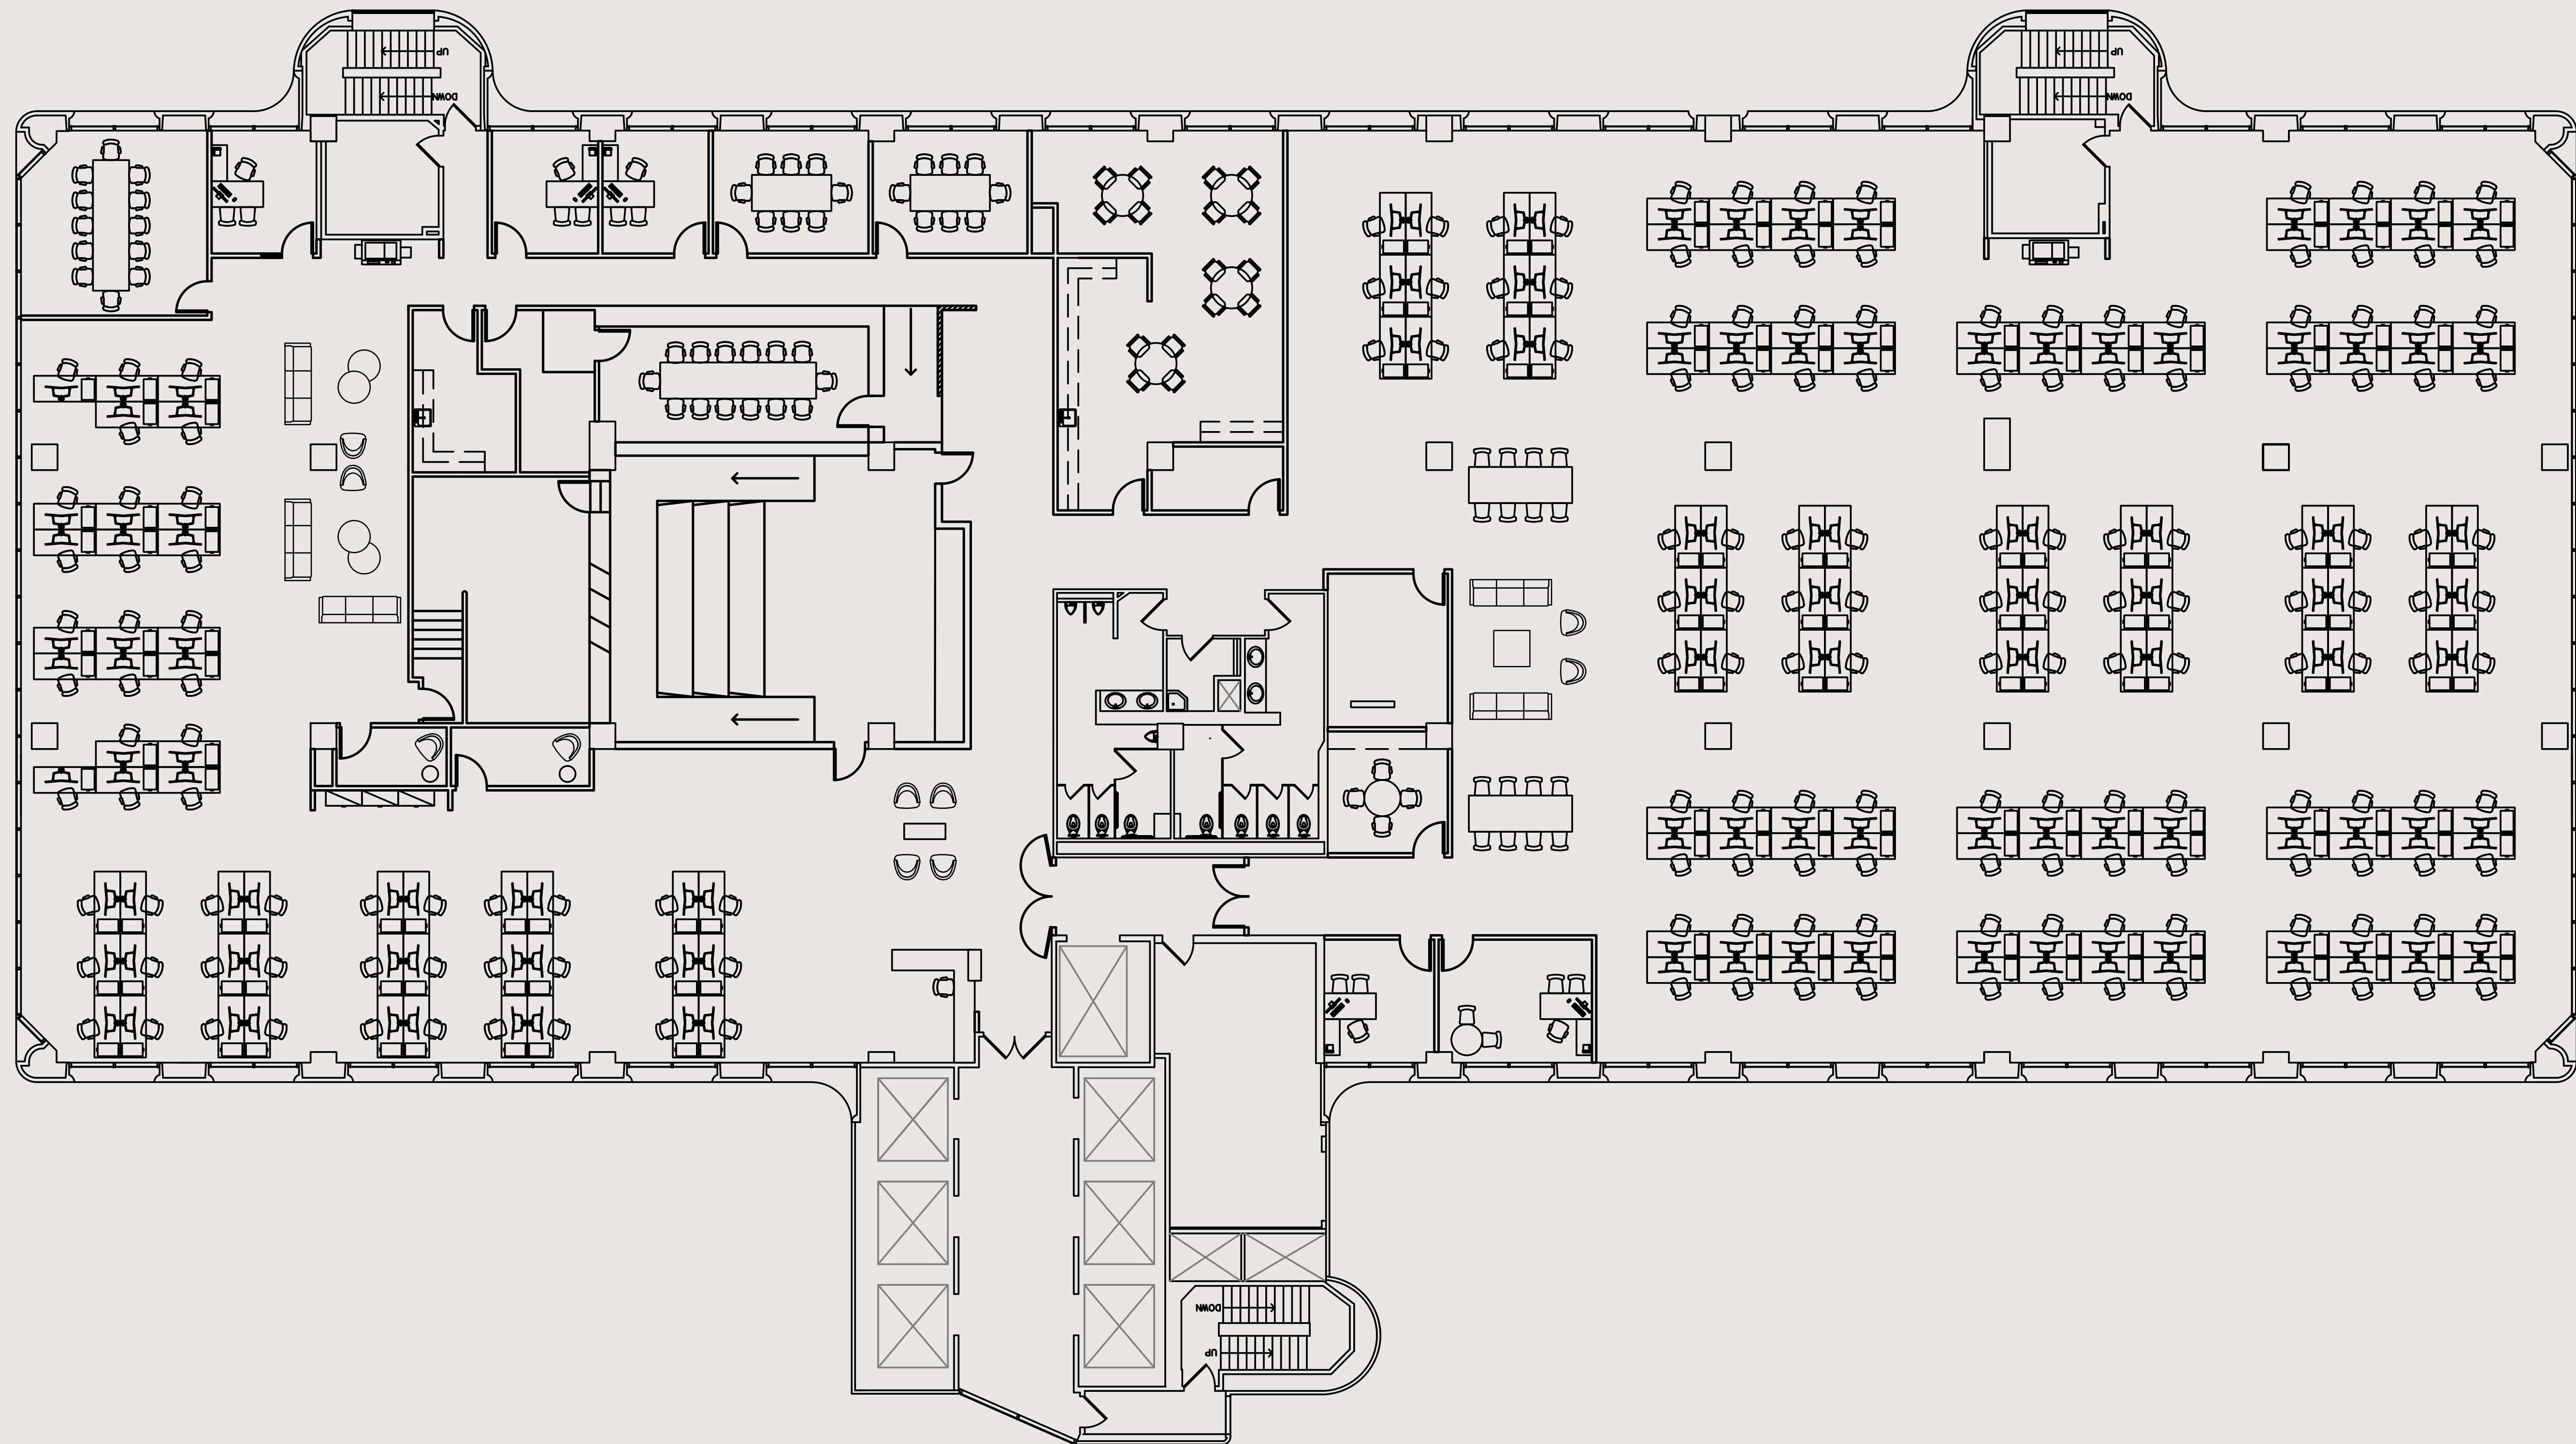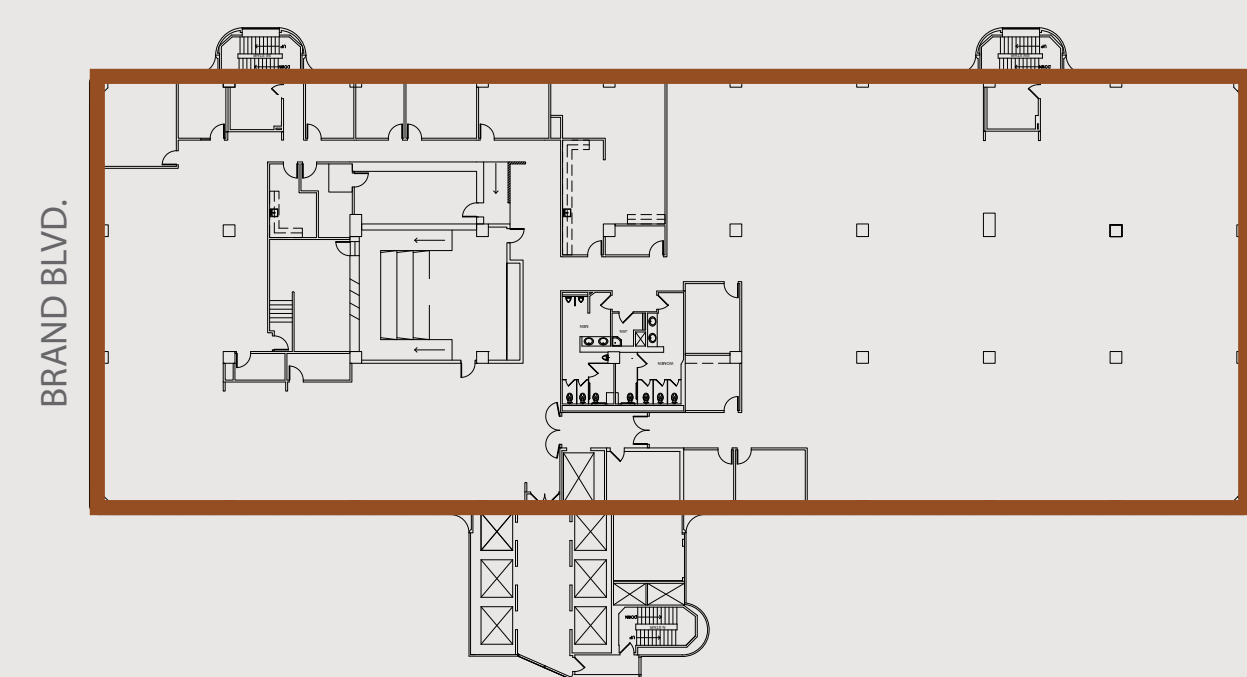

For leasing information please contact:
Scott A. Unger
626.873.1803 | scott.unger@kidder.com

