SUITE: 155

RSF: 1,876

611BRAND

AS-BUILT CONFIGURATION

RECEPTION.....1


LOCKER ROOMS.....4


THERAPY ROOMS.....3

PRIVATE RESTROOMS.....1

KEY PLAN

Not to scale, furniture and appliances not included

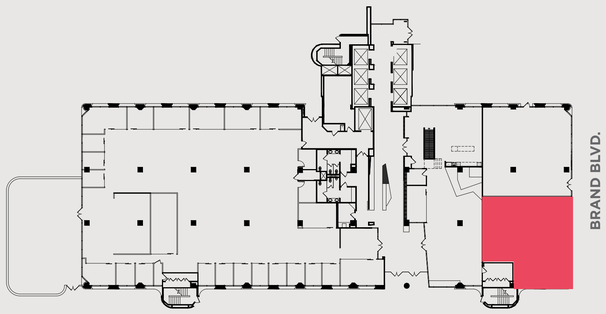

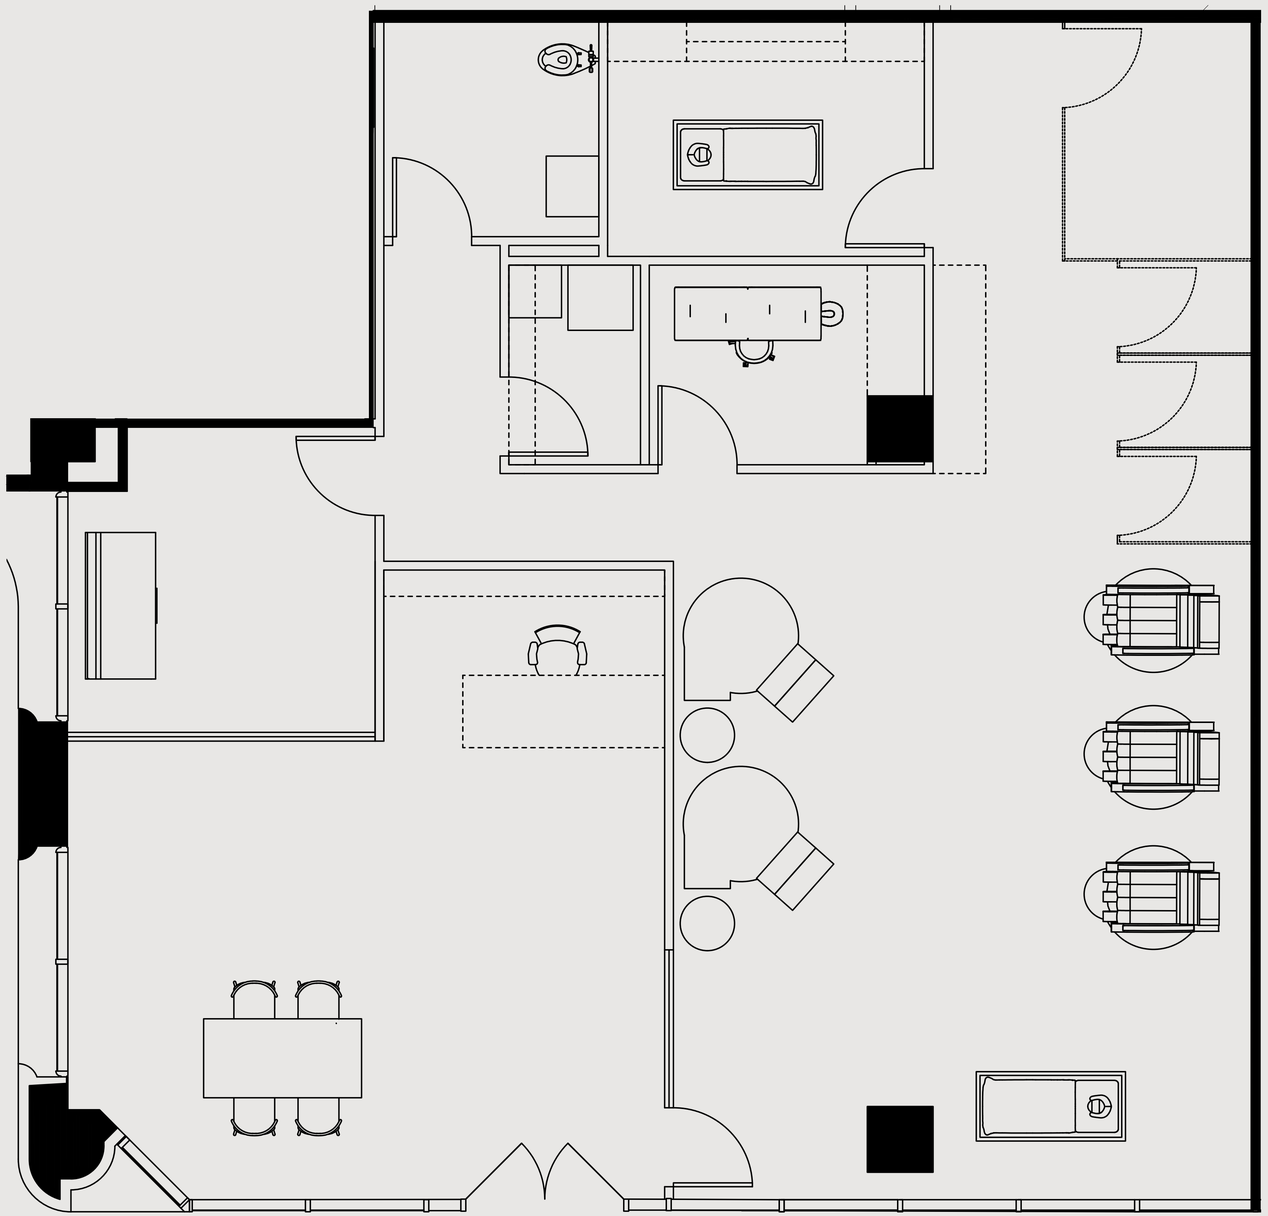

For leasing information please contact:
USALEASING@ONNI.COM